
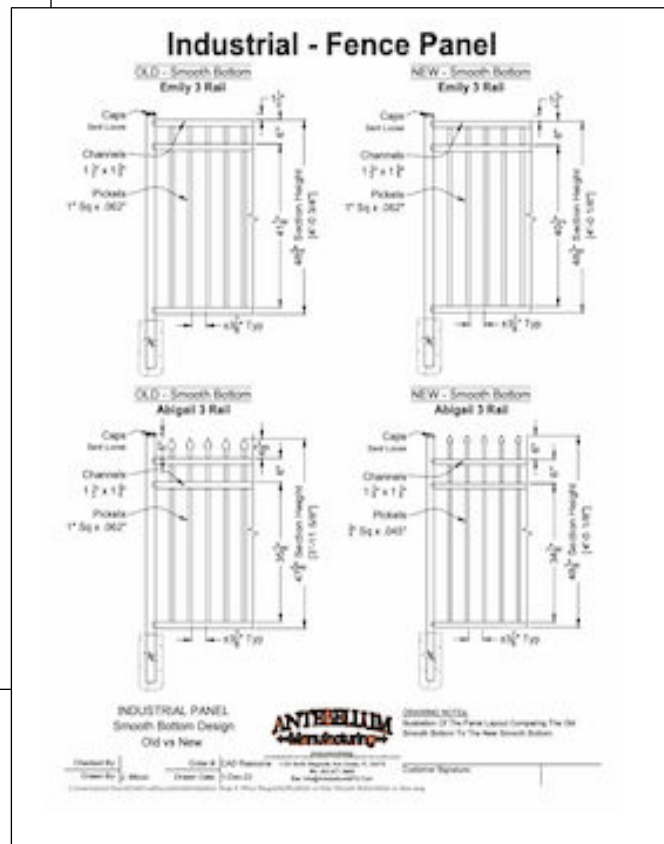


# New Smooth Bottom Panel

To bring all Smooth Bottom panels to a “truer” height for ALL grades we have adjusted the rail placement on the **Commercial** and **Industrial** panels slightly as shown on the attached CAD example.


New jobs will not be affected. However, if you are trying to match a job that was built prior to November 7, 2023 with a “replacement” panel or possibly an “add on” this should be noted on the order form when placing orders. The Customer Service team has been screening all orders accordingly as they are received but we wanted to provide you with additional information and support with the CADs to assist going forward. If you should have any questions or need additional assistance, please feel free to reach out to our customer service team.

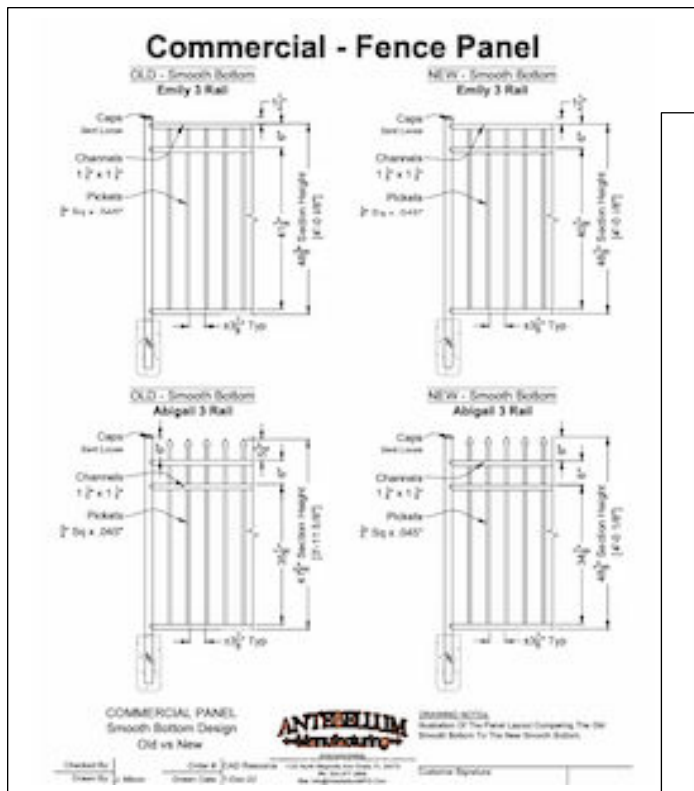

# Commercial - Fence Panel


OLD - Smooth Bottom

Emily 3 Rail

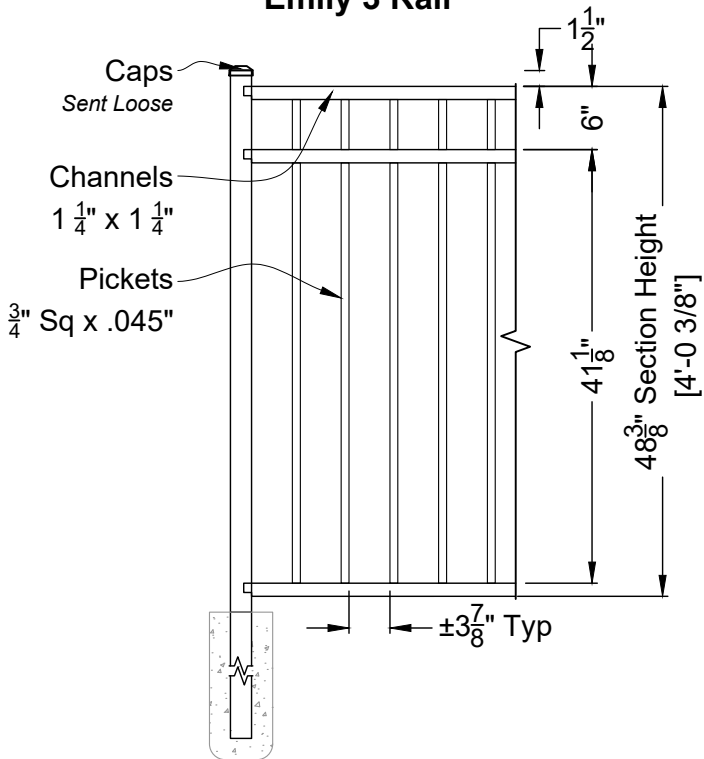


NEW - Smooth Bottom

Emily 3 Rail

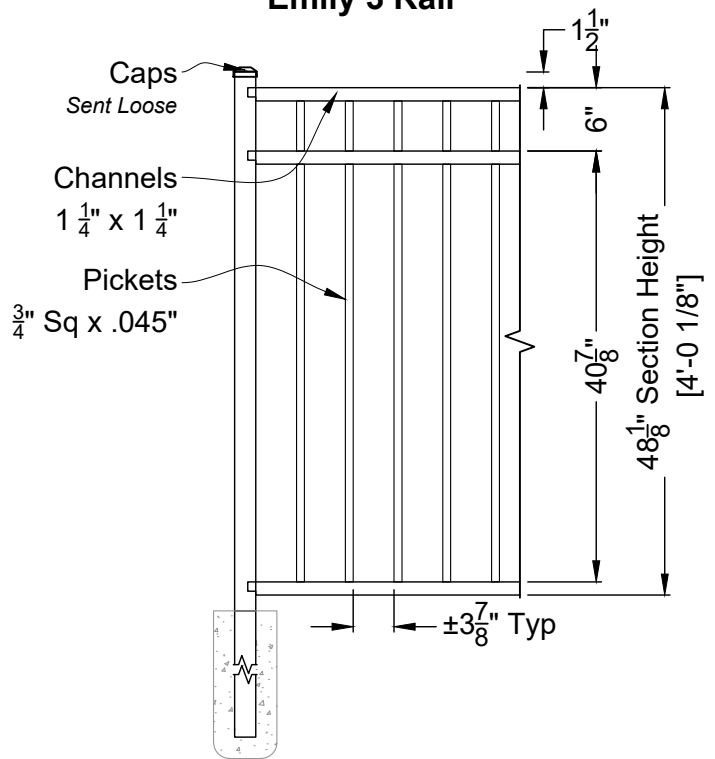


OLD - Smooth Bottom

Abigail 3 Rail

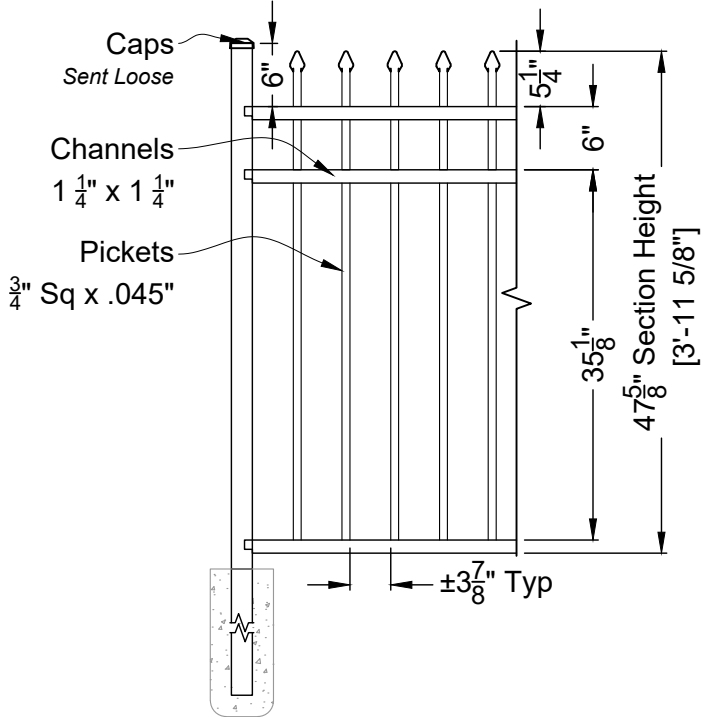

NEW - Smooth Bottom

Abigail 3 Rail

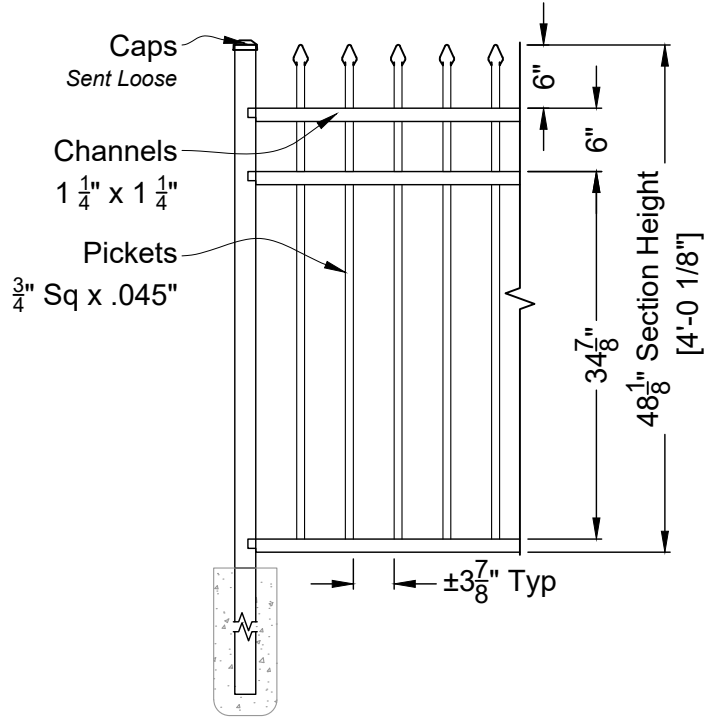

COMMERCIAL PANEL  
Smooth Bottom Design  
Old vs New



DRAWING NOTES:

Illustration Of The Panel Layout Comparing The Old Smooth Bottom To The New Smooth Bottom.

Checked By:

Drawn By: J. Mixon

Order #: CAD Resource

Drawn Date: 1-Dec-22

DO NOT SCALE DRAWING.  
FOR DIMENSIONS NOT SHOWN CONTACT PLAN COORDINATOR FOR CLARIFICATION

1120 North Magnolia Ave Ocala, FL 34475

Ph: 352.877.3888


Em: Info@AntebellumMFG.Com

Customer Signature: \_\_\_\_\_

# Industrial - Fence Panel


OLD - Smooth Bottom

Emily 3 Rail

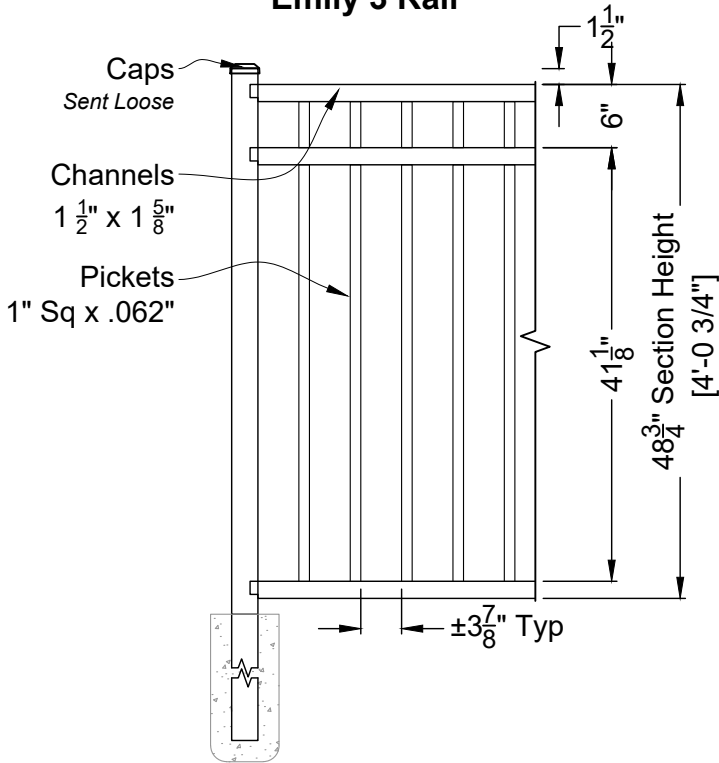


NEW - Smooth Bottom

Emily 3 Rail

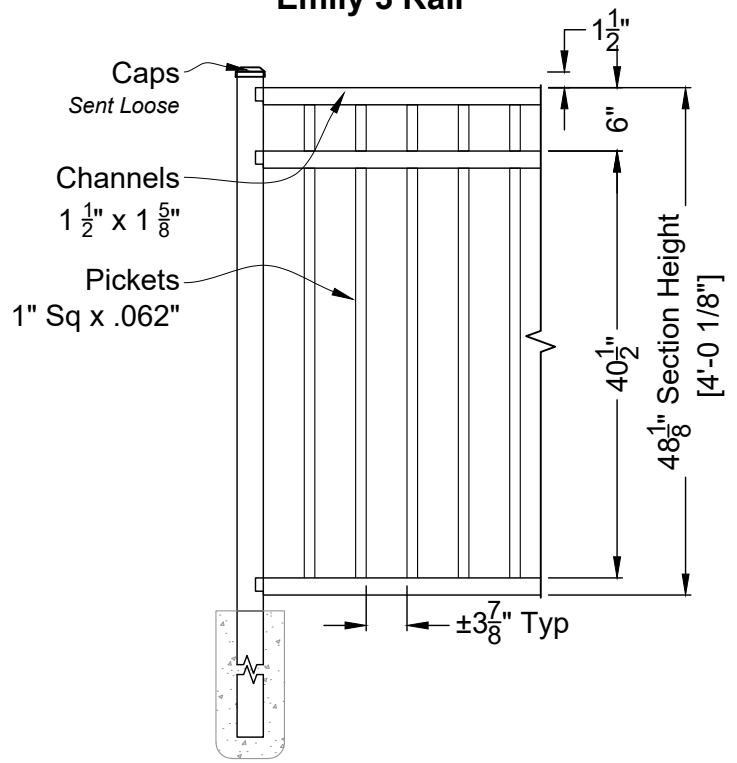


OLD - Smooth Bottom

Abigail 3 Rail

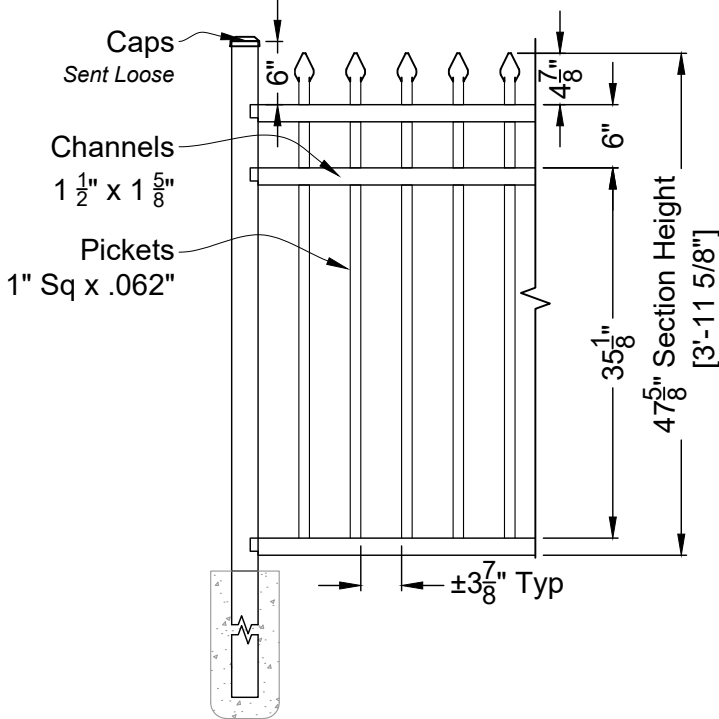

NEW - Smooth Bottom

Abigail 3 Rail

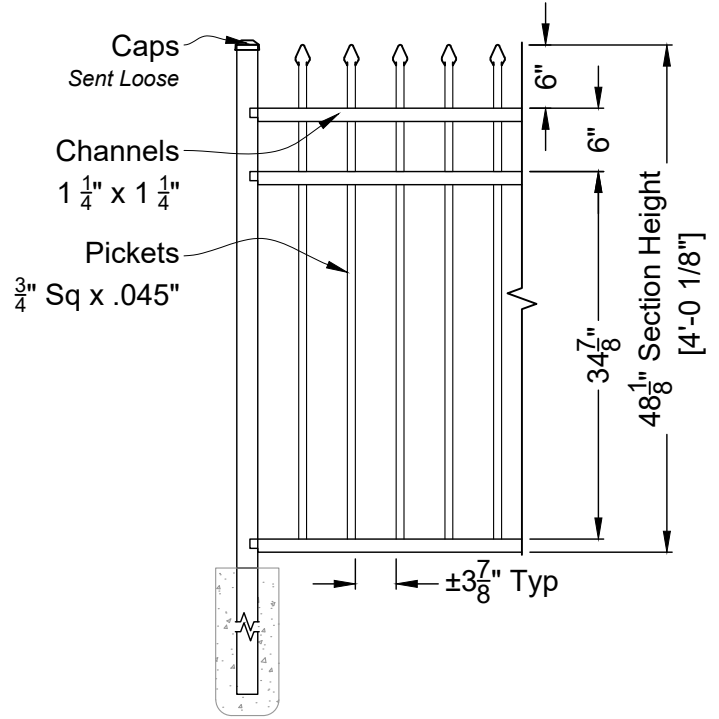

INDUSTRIAL PANEL  
Smooth Bottom Design  
Old vs New



DRAWING NOTES:

Illustration Of The Panel Layout Comparing The Old Smooth Bottom To The New Smooth Bottom.

Checked By:

Drawn By: J. Mixon

Order #: CAD Resource

Drawn Date: 1-Dec-22

DO NOT SCALE DRAWING.  
FOR DIMENSIONS NOT SHOWN CONTACT PLAN COORDINATOR FOR CLARIFICATION

1120 North Magnolia Ave Ocala, FL 34475

Ph: 352.877.3888

Em: Info@AntebellumMFG.Com

Customer Signature: \_\_\_\_\_