

ANTEBELLUM Manufacturing

March Updates and Information


3-1-24

Website Updates

Antebellum is happy to announce that we will be working toward adding updates and resources to our website. It is currently a “work in process”. We have added an informative March Update Newsletter, Fence & Gate Spec Sheet, Estate Gate Spec Sheet Residential panel CAD’s, a D&D hardware brochure, various helpful illustrations etc. We look forward to adding much more to better serve our customers by providing useful resources and helpful information.


Check it out!

<https://antebellumdecorativefences.com>

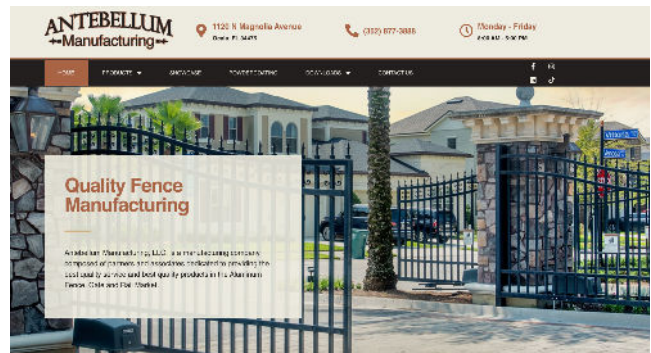

Corporate Rail

Antebellum now offers Corporate Rail. Corp Rail is very similar to Commercial product but varies in the build of the product as shown in the CAD example attached. Corp Rail is a great option for those that would like a “Brawnier” appearance such as an industrial panel, without requiring the full strength of one. Corp Rail is competitively priced the same as Commercial product and can be requested by noting it on the order form. If you should have any additional questions please reach out to the sales team for assistance.

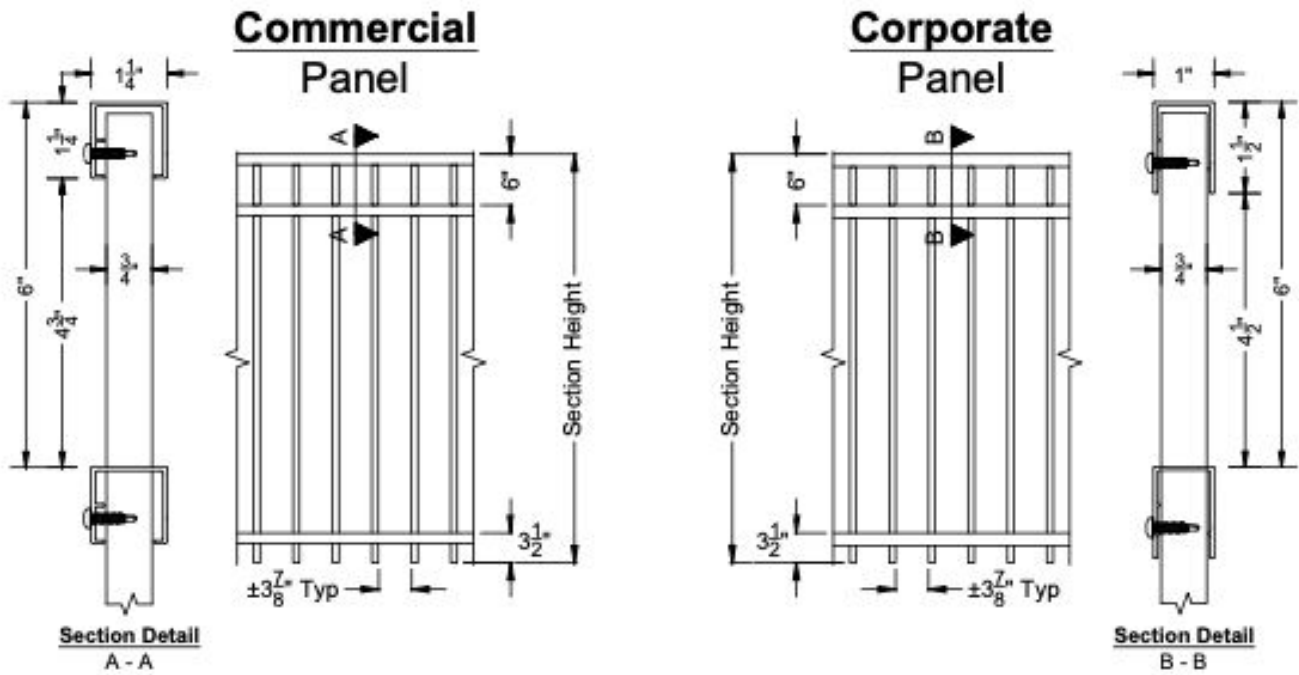

Emily 3 Rail - Rake Bottom
Commercial vs Corporate
ID#: COM VS CORP



ANTEBELLUM MANUFACTURING
FOR DIMENSIONS NOT SHOWN SEE OUR FULL CATALOG FOR CLARIFICATION
1120 North Magnolia Ave Ocala, FL 34475
Ph: 352.877.3688
E-mail: info@AntebellumMFG.com

DRAWING NOTES:

Checked By: _____ Order #: CAD Resource
Drawn By: J. Nixon Drawn Date: 21-Feb-24



Customer Signature: _____ Rev 00

C:\Users\jared.Mason\Desktop\Documents\Antebellum Shop 9 Drive Request\Draw\Corporate vs Commercial\Com vs Corp.dwg

New Smooth Bottom Panel


To bring all Smooth Bottom panels to a “truer” height for ALL grades we have adjusted the rail placement on the **Commercial** and **Industrial** panels slightly as shown on the attached CAD example.

New jobs will not be affected. However, if you are trying to match a job that was built prior to November 7, 2023 with a “replacement” panel or possibly an “add on” this should be noted on the order form when placing orders. The Customer Service team has been screening all orders accordingly as they are received but we wanted to provide you with additional information and support with the CADs to assist going forward. If you should have any questions or need additional assistance, please feel free to reach out to our customer service team.

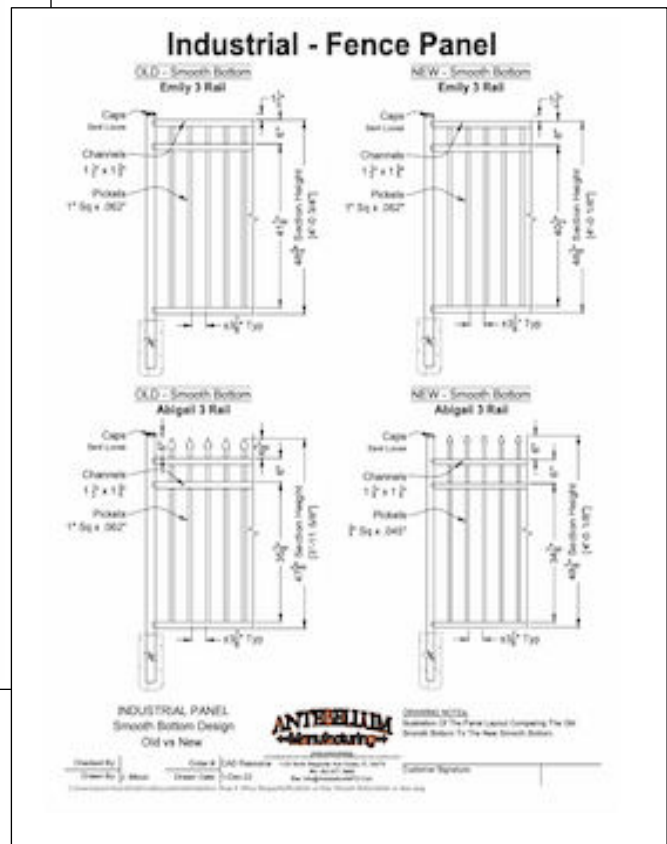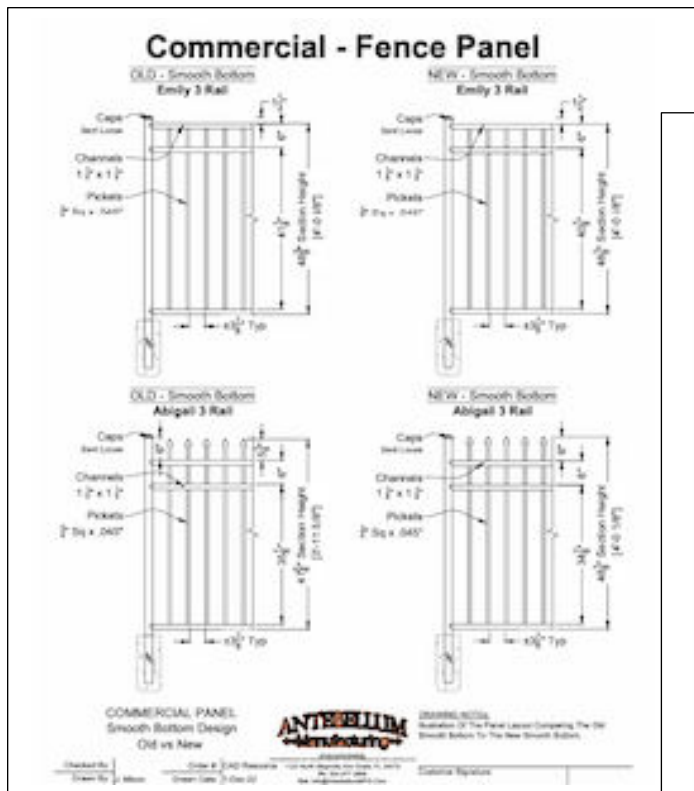


Commercial - Fence Panel


OLD - Smooth Bottom
Emily 3 Rail

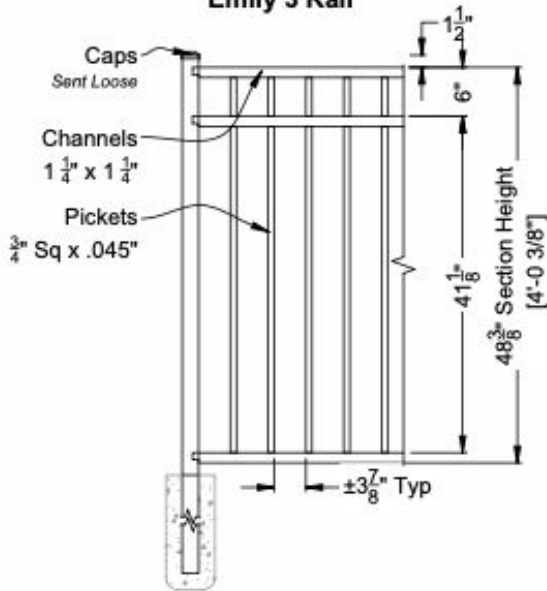


NEW - Smooth Bottom
Emily 3 Rail

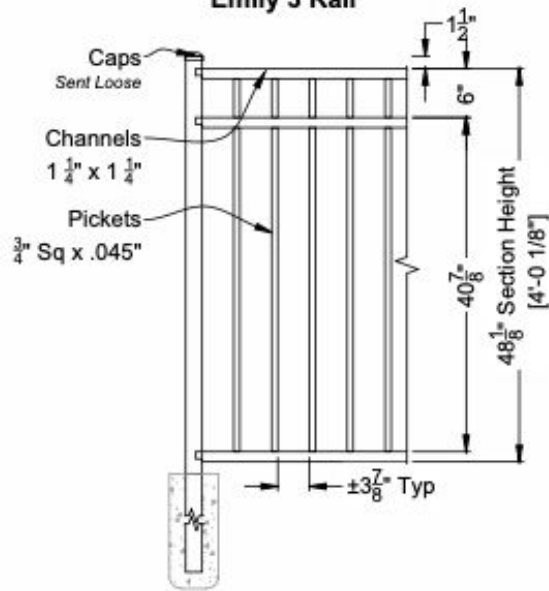

OLD - Smooth Bottom
Abigail 3 Rail

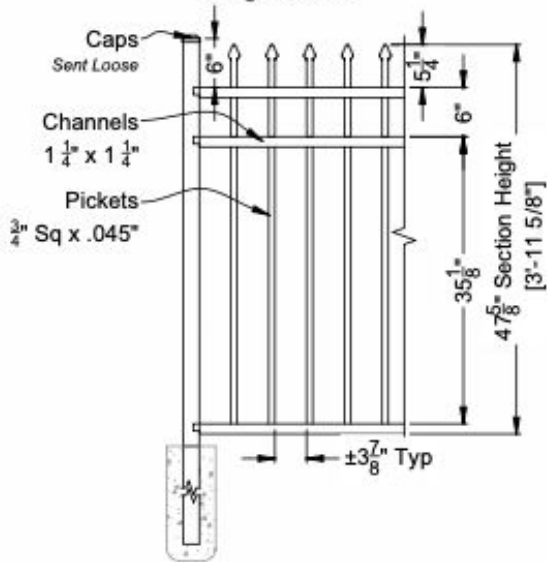

NEW - Smooth Bottom
Abigail 3 Rail

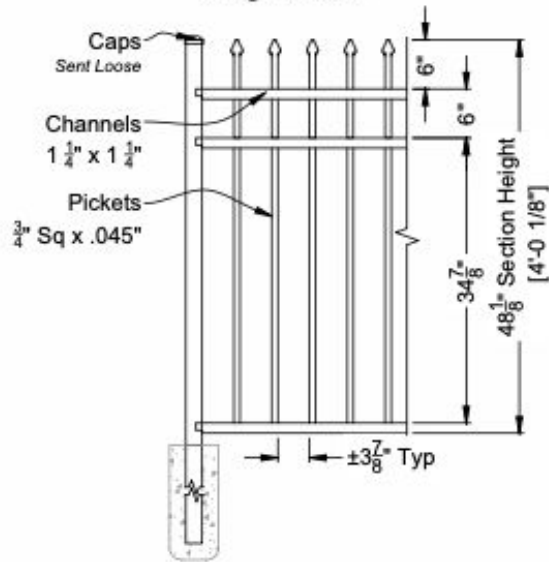

COMMERCIAL PANEL
Smooth Bottom Design
Old vs New



DRAWING NOTES:
Illustration Of The Panel Layout Comparing The Old Smooth Bottom To The New Smooth Bottom.

Checked By:

Order #:

CAD Resource

1120 North Magnolia Ave Ocala, FL 34475

Drawn By: J. Mixon

Drawn Date: 1-Dec-22


Ph: 352.677.3888
Etc: info@AntebellumMFG.com

Customer Signature: _____

Industrial - Fence Panel


OLD - Smooth Bottom

Emily 3 Rail

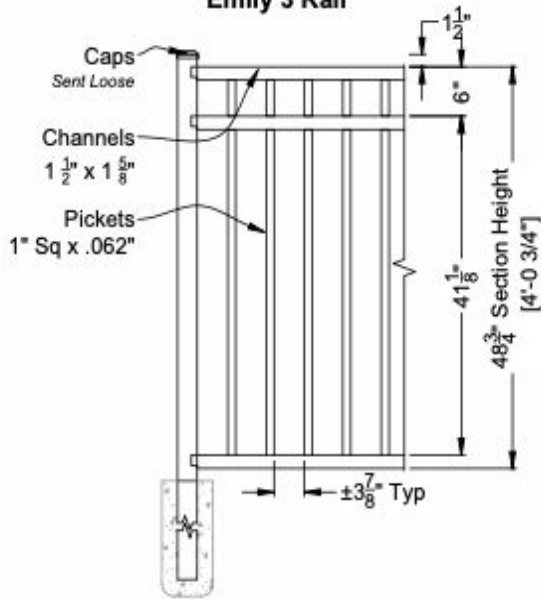


NEW - Smooth Bottom

Emily 3 Rail

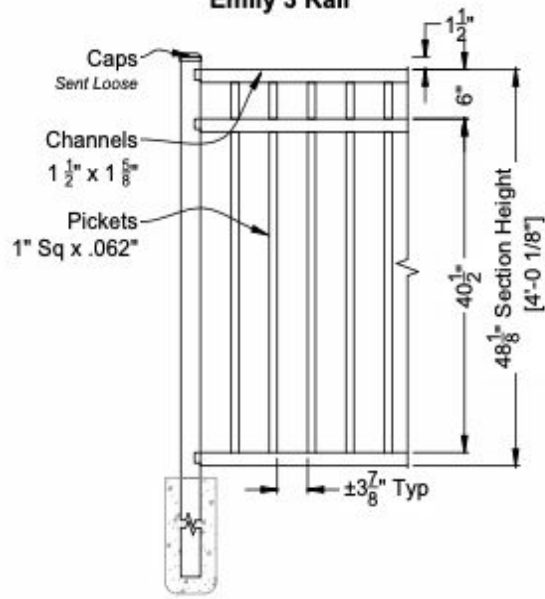


OLD - Smooth Bottom

Abigail 3 Rail

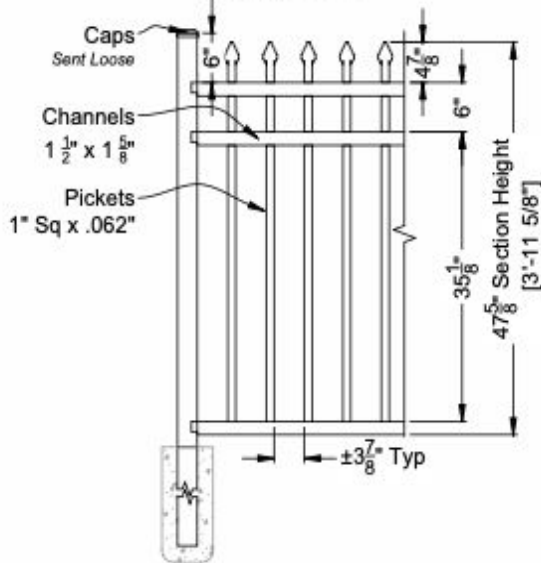

NEW - Smooth Bottom

Abigail 3 Rail

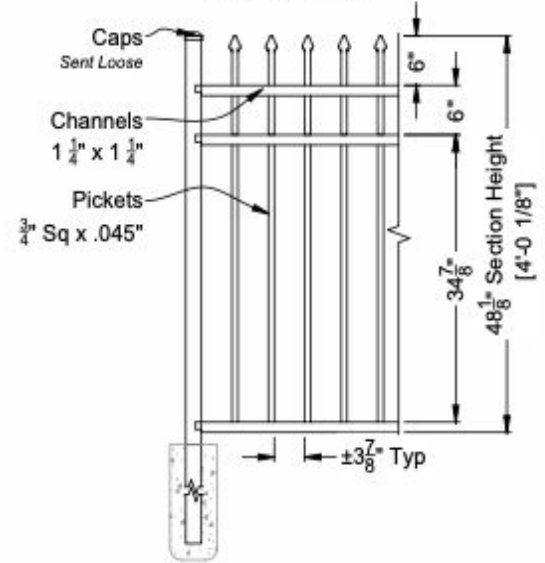

INDUSTRIAL PANEL
Smooth Bottom Design
Old vs New



DRAWING NOTES:

Illustration Of The Panel Layout Comparing The Old Smooth Bottom To The New Smooth Bottom.

Checked By:

Order #:

CAD Resource

1120 North Magnolia Ave Ocala, FL 34475

Drawn By: J. Mixon

Drawn Date:

1-Dec-22

Ph: 352.677.3885

Em: info@AntebellumMFG.com

Customer Signature:



Accounting Software Update Effective April 1st 2024

For those customers that are not sales tax exempt, please be advised that beginning April 1st, Antebellum will be using new software to calculate sales tax. Due to this change, it is necessary that payments be made based on the information on the Invoice, and not the Sales Order; particularly if the Sales Order is dated prior to April 1st. Similarly, Antebellum is legally required to collect sales tax based on the delivery address; therefore, if the delivery address is changed, payment must be made based on the updated Invoice. Lastly, if your order is subject to discretionary (county or otherwise) sales surtax limits, the software will apply those limits; however, the total sales tax due will be calculated in one lump sum and Antebellum will no longer have the ability to separate sales tax into the line items showing state and discretionary tax. If you have any questions, please feel free to reach out to our accounting department. Thank you for your assistance and attention to this matter.